


KEY PLAN
NOT TO SCALE



RECORD DRAWING

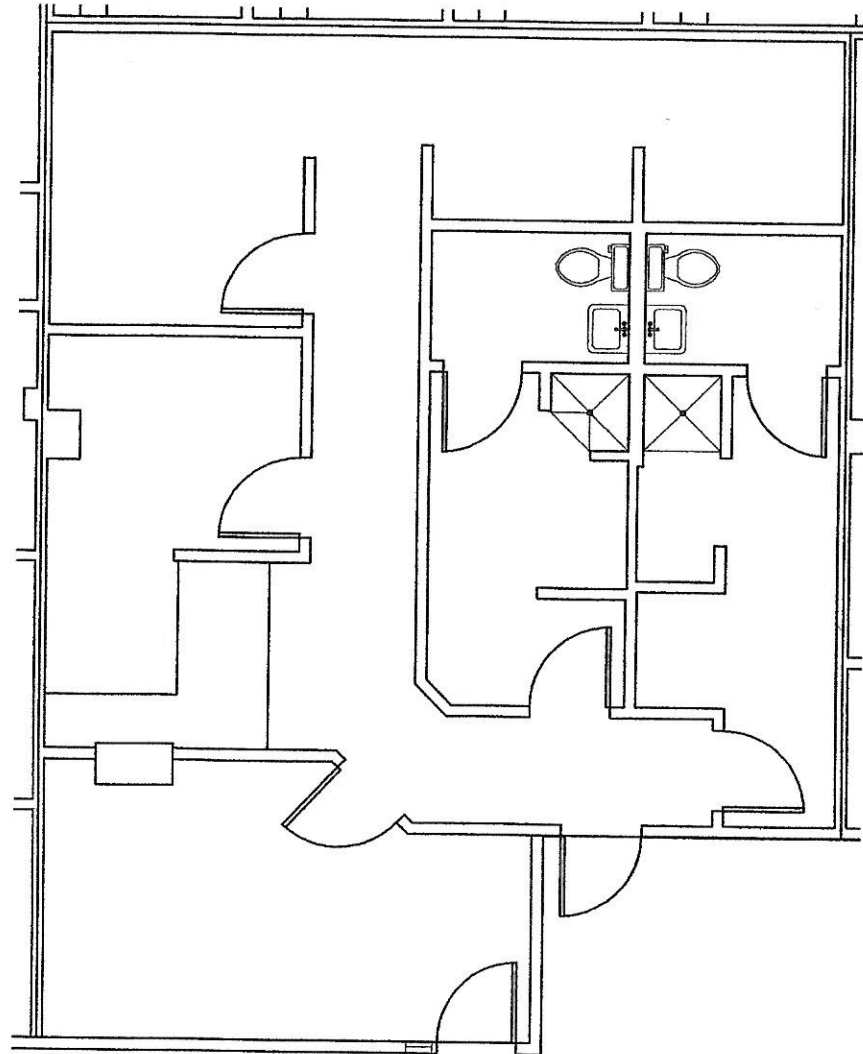

EASTSIDE MEDICAL PLAZA I

SUITE 140 B- 1,055 USF 1,217 RSF



FIRST FLOOR
1700 TREE LANE
SNELLVILLE, GEORGIA

ARCHITECTURAL ENVIRONMENTS
9019 OVERLOOK BLVD. SUITE C-3 BRENTWOOD, TN 37027

www.aenashvle.com